



ECCV DI-1 Injection Well

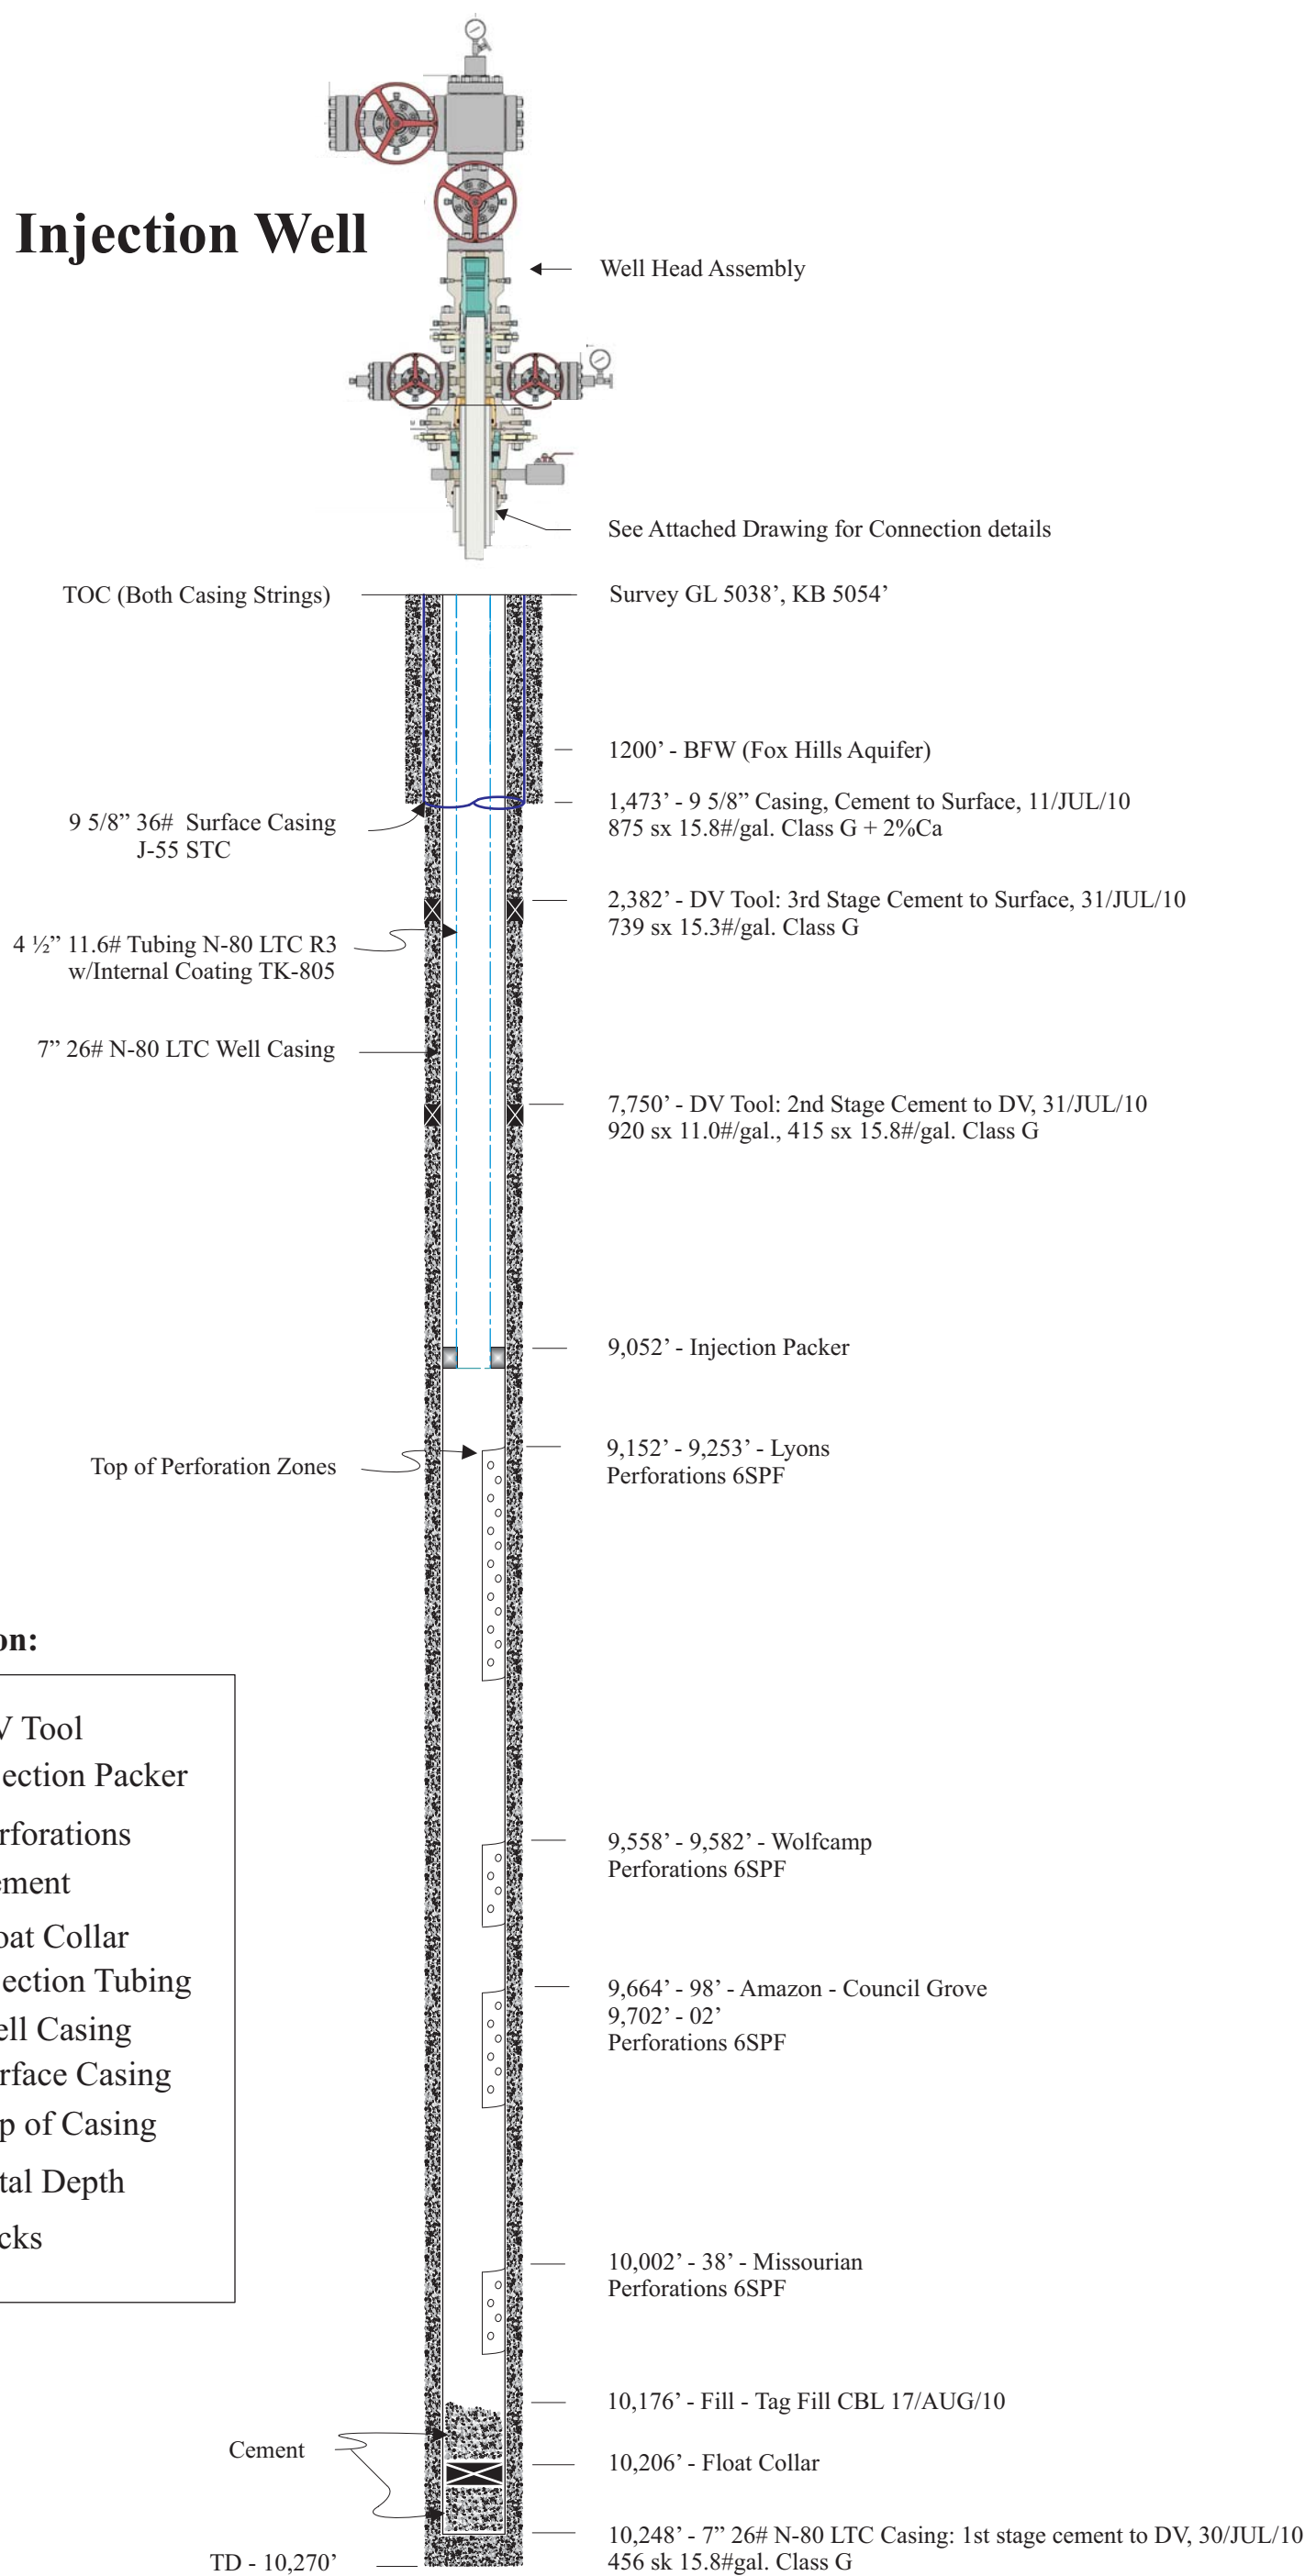

Symbol Description:

	DV Tool
	Injection Packer
	Perforations
	Cement
	Float Collar
	Injection Tubing
	Well Casing
	Surface Casing
TOC	Top of Casing
TD	Total Depth
SX	Sacks

Hydro Resources - Rocky Mountain, Inc. Job #RKYR00652	Client: East Cherry Creek Valley WSD	View: Elevation Drawing (As Built)
	Project: ECCV DI-1 Injection Well	Description: Page 1 of 1
Date: 10/21/10	Drawing By: Randy Parsons	Not to Scale

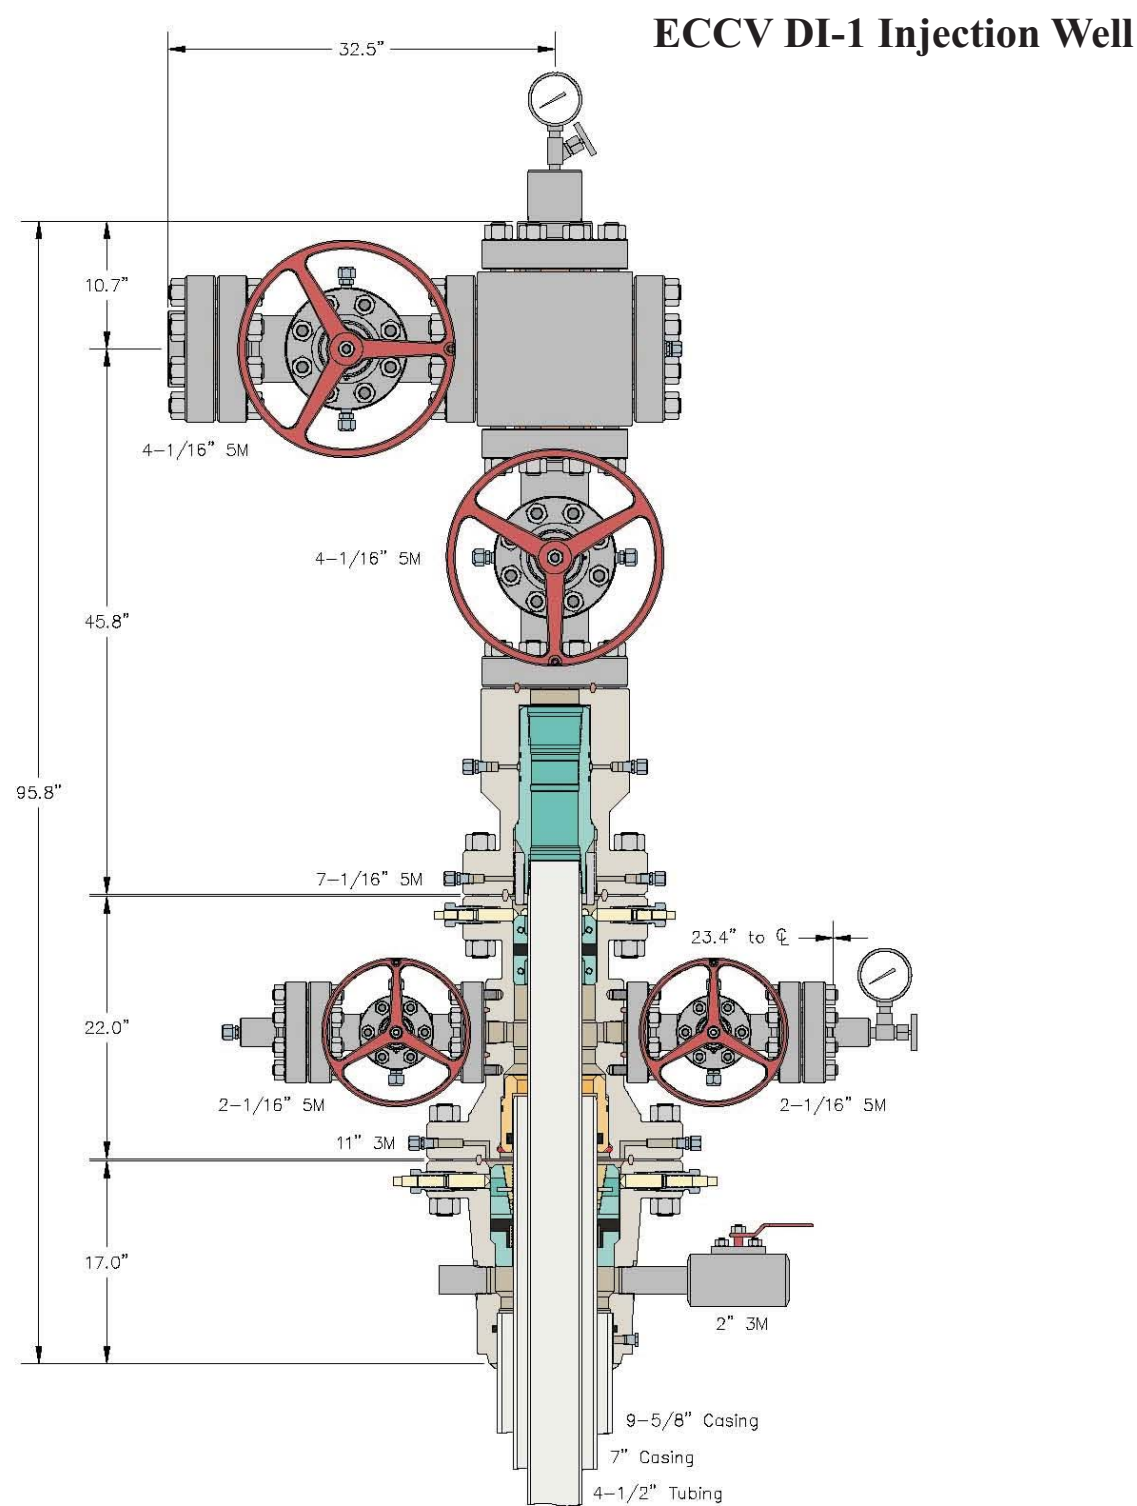

This drawing is the property of Wood Group Pressure Control and is considered confidential. Unless otherwise approved in writing, neither it nor its contents may be used, copied, transmitted or reproduced except for the sole purpose of Wood Group Pressure Control.

“As Built”

WOOD GROUP PRESSURE CONTROL		Hydro Resources ECCV DI-1 Injection Well	
9-5/8" x 7" x 4-1/2" 5M Conventional Wellhead Assembly, With T-EBS Tubing Head, T-2W Tubing Hanger, O10 Coupling and Adapter Flange		DRAWN	BJS 29JUN10
		APPRV	VJK 29JUN10
		DRAWING NO.	AE18771-A